

**PROJECT ROOM CONTENTS (PRC) Room-by-Room
FYXX Hospital Modernization, Installation Name**

SUBMITTAL:	DS2	DATE:	01/31/2025
Contractor Name:		Functional Area:	STAFF AND ADMINISTRATION
Department:	DENTAL CLINIC	Room Number:	114 – CONF ROOM
Room Name:	Conference Room	Staff #:	0
Room Code:	CRA02	Record Drawing #:	4Q1-11

OPR	JSN	Nomenclature	Qty	Fund Source	*Utilities						Existing ECN #	Connect to LAN Y/N	Existing Rm #	Remarks
					Util1	Util2	Util3	Util4	Util5	Util6				
MDG	A1011	Telephone, Desk, 1 Line	1	Reuse	-	-	-	-	-	-		Y	114	
IO KTR	A5075	Dispenser, Soap, Disposable	1	PP	-	-	-	-	-	-		N		DS1 - Soap Added
GC	A5080	Dispenser, Paper Towel, SS, Surface Mounted	1	RPIE	-	-	-	-	-	-		N		DS1 - Paper Towel Added
IO KTR	A5212	Bracket, Television, Wall-Mounted, Tilt/Angle	2	PP	-	-	-	-	-	-		N		
GC	A5220	Wooden Wall Support Block, Internal Wall, TV	2	RPIE	-	-	-	-	-	-		N		
GC	C01C0	Cabinet, U/C/B, 1 Shelf, 1 Drawer, 1 DO, 36x18x22	1	RPIE	-	-	-	-	-	-		N		DS1 - decreased cabinet size to 18"w
GC	C02D0	Cabinet, U/C/B, 4 Drawer, 36x24x22	1	RPIE	-	-	-	-	-	-		N		
GC	C03P0	Cabinet, Sink, U/C/B, 2 Door, 30in W	1	RPIE	-	-	-	-	-	-		N		DS1 - decreased cabinet size to 30"w
GC	CS010	Sink, SS, Single Compartment, 7.5x12x12 ID	1	RPIE	D	-	-	-	-	-		N		DS1 - Sink added
GC	CT020	Countertop, Solid Surface	1	RPIE	-	-	-	-	-	-		N		DS1 - Countertop added for casework
IO KTR	E0042	Work center, Computer, Free Standing	1	PP	-	-	-	-	-	-		Y		
IO KTR	F0220	Chair, Conference	24	PP	-	-	-	-	-	-		N		
IO KTR	F0235	Chair, Conference, Side	16	PP	-	-	-	-	-	-		N		
IO KTR	F0755	Table, Conference, Wood	2	PP	-	-	-	-	-	-		N		
MDG	F2000	Wastebasket, Fire Resistant, Thermoset Polyester	2	Reuse	-	-	-	-	-	-		N	114	
IO KTR	F3200	Clock, Digital Display, Month-Day-4" Time-C/F Temp	1	PP	-	-	-	-	-	-		N		
MDG	M0512	Television, HDTV, Large Screen, 60	1	Reuse	-	A	-	-	-	-	7273	Y	114	
MDG	M0512	Television, HDTV, Large Screen, 60	1	Reuse	-	A	-	-	-	-	7274	Y	114	
MDG	M1801	Computer, Micro-processing, w/Flat Panel Monitor	1	Reuse	-	A	-	-	-	-		Y	114	

**Highlight ALL
changes from
the original
award PRC**


Utilizing the Master PRC list content, create individual room-by-room PDFs for each room or project space containing RPIE/PP, new and reuse, including corridors, closets and building exterior. Include information found on this sample document including a room layout from the corresponding PP composite drawing (aka Record Drawing). NOTE: The PRC RBRs are to be an extraction of information contained on the Master PRC spreadsheet and the two documents shall be fully coordinated. This format is to be presented in user meetings, included in the MTF Transition Plan as well as posted for government inspections.

***NOTE: Refer to MIL-STD 1691 for Utility Legend**

PROJECT ROOM CONTENTS (PRC)
FYXX Hospital Modernization, Installation Name

SUBMITTAL: DS2
Contractor Name:
Department: DENTAL CLINIC
Room Name: Conference Room
Room Code: CRA02

DATE: 01/31/2025
Functional Area: STAFF AND ADMINISTRATION
Room Number: 114 – CONF ROOM
Staff #: 0
Record Drawing #: 4Q1-11

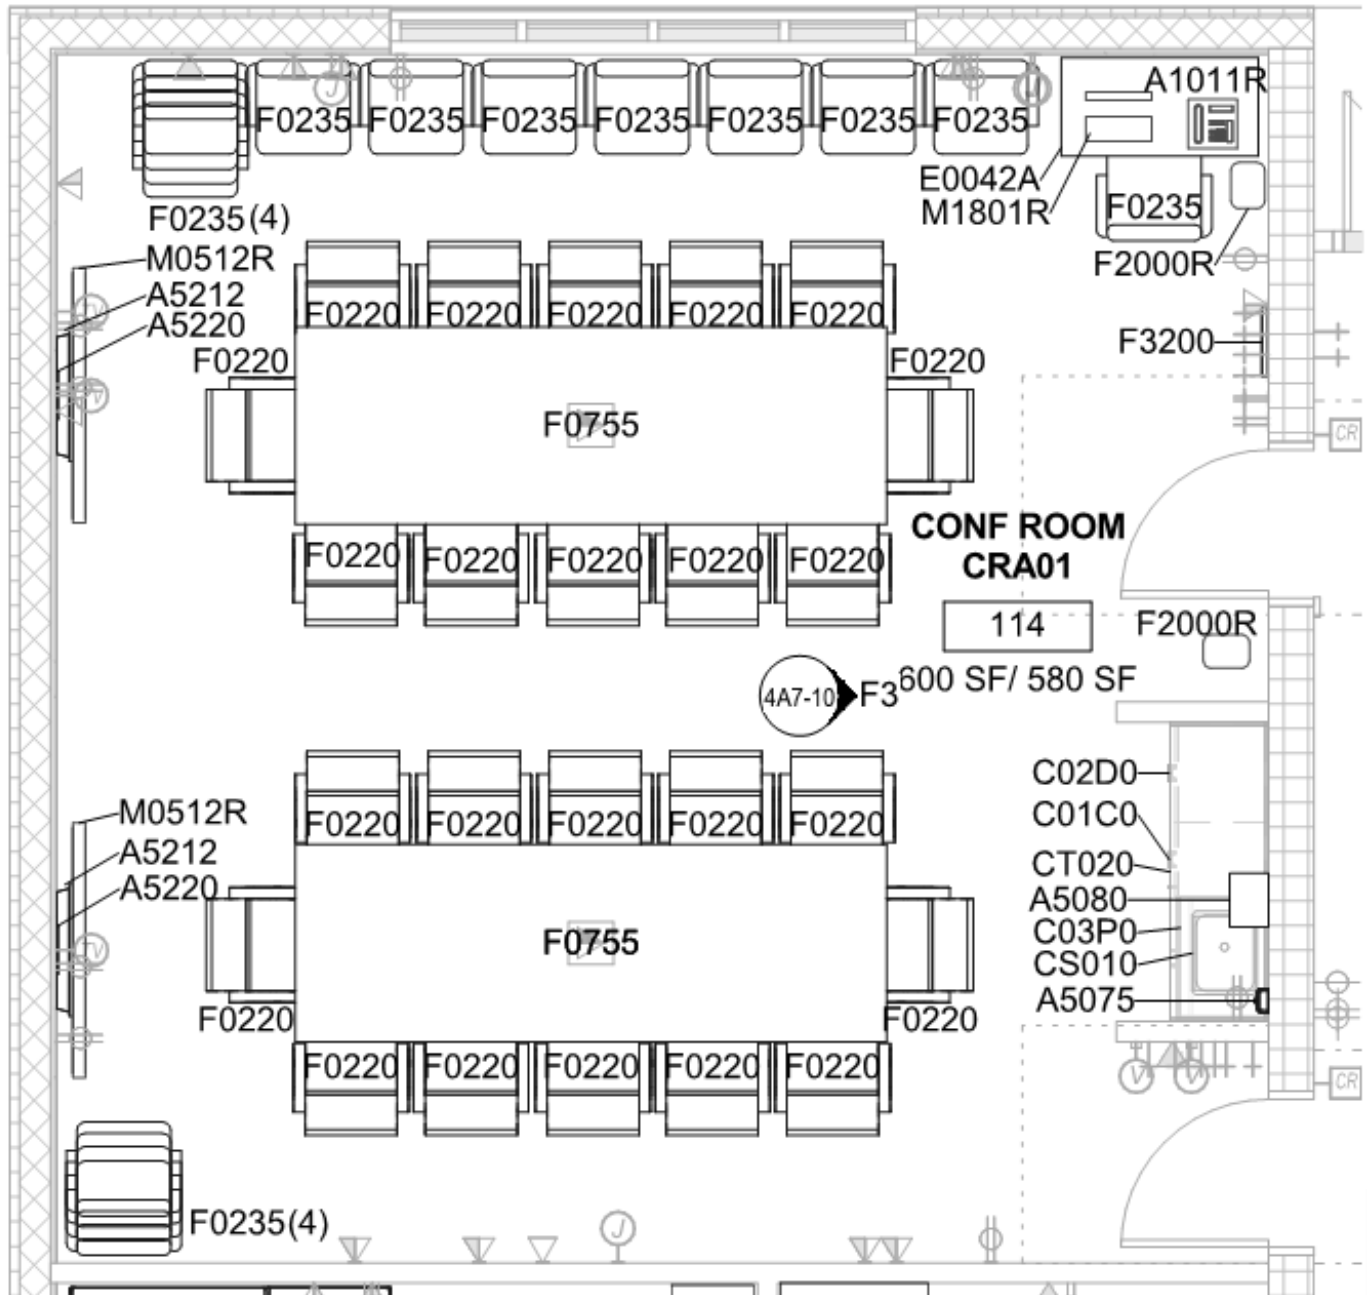

EXAMPLE